

STATE OF CALIFORNIA - DEPARTMENT OF TRANSPORTATION

Caltrans

DESIGN OVERSIGHT

BEHZAD GOLEMOHAMMADI

CALCULATED/DESIGNED BY

CHECKED BY

DATE 01/0

01/0

REVISED BY

DATE REVISED

SYN

FW



DIST	COUNTY	ROUTE	KILOMETER TOTAL PROJECT	POST PROJECT	SHEET NO	TOTAL SHEETS
04	SF, Alameda	80	12.2/14.3	0.0/4.0	407a	1204

Syn Yee Chin

03/08/10

REGISTERED ELECTRICAL ENGINEER


DATE

05-06-2010
PLANS APPROVAL DATE


PB AMERICAS, Inc.
A Parsons Brinckerhoff Company
303 Second St., Suite 700N
San Francisco, CA 94107-1317

The State of California or its officers or agents shall not be responsible for the accuracy or completeness of electronic copies of this plan sheet.


Caltrans now has a web site. To get to the web site, go to <http://www.dot.ca.gov>

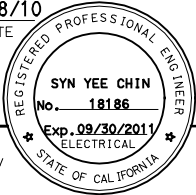

- NOTES:
- This plan sheet is a record drawing from Oakland Touchdown 1 contract. The Contractor shall verify the existing installation. See sheet E-30 of Oakland Touchdown 1, contract No. 04-0120L4.
 - The installed components shall not be limited to the ones listed below, but shall be a complete installation. For details, see Bridge Structures Girder Westbound, typical Detail sheets.
 - Furnish and install (4) one-inch inner-ducts with TOS fiber optic cables in one inner-duct, into existing conduit shown on this drawing. Refer to riser diagram on sheets E-978 through E-981 and detail on E-973.
 - Inspect for system ground continuity.
 - All cable trays and conduits shown on this drawing are existing. Bold ones are to be used for pulling cable.

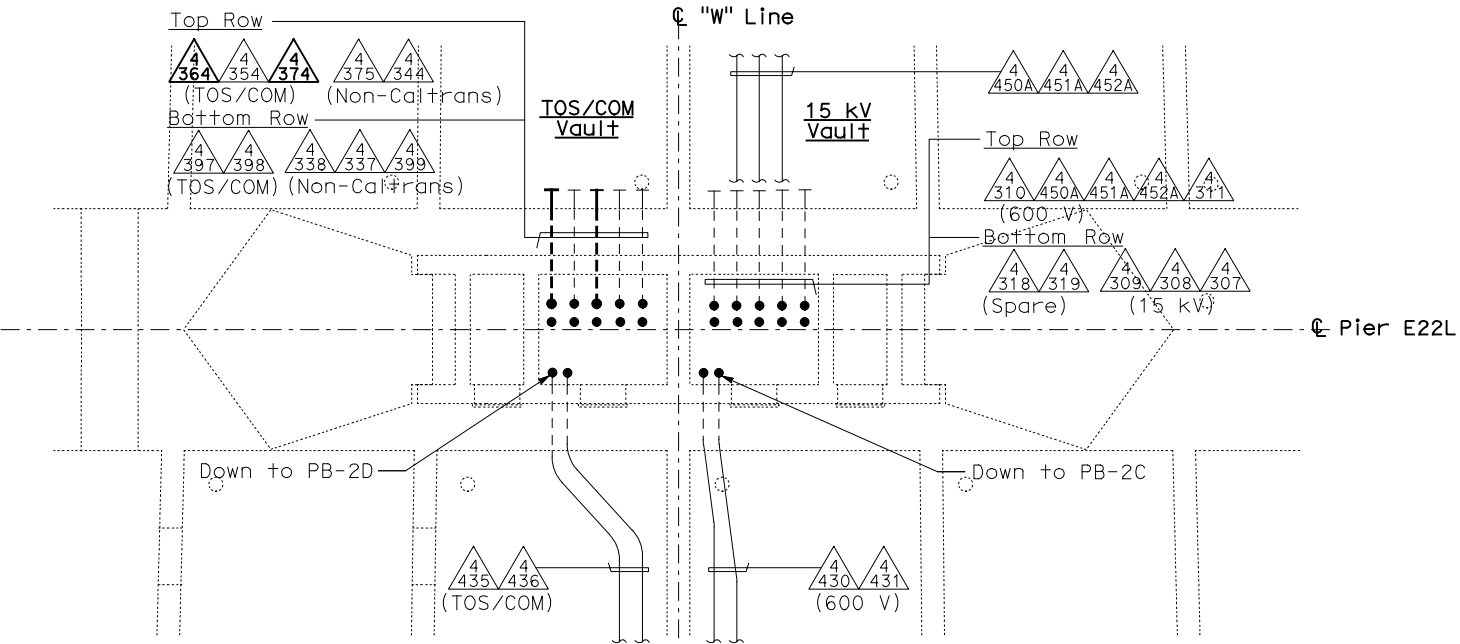

PIER E22L - GIRDER CONDUIT PLAN

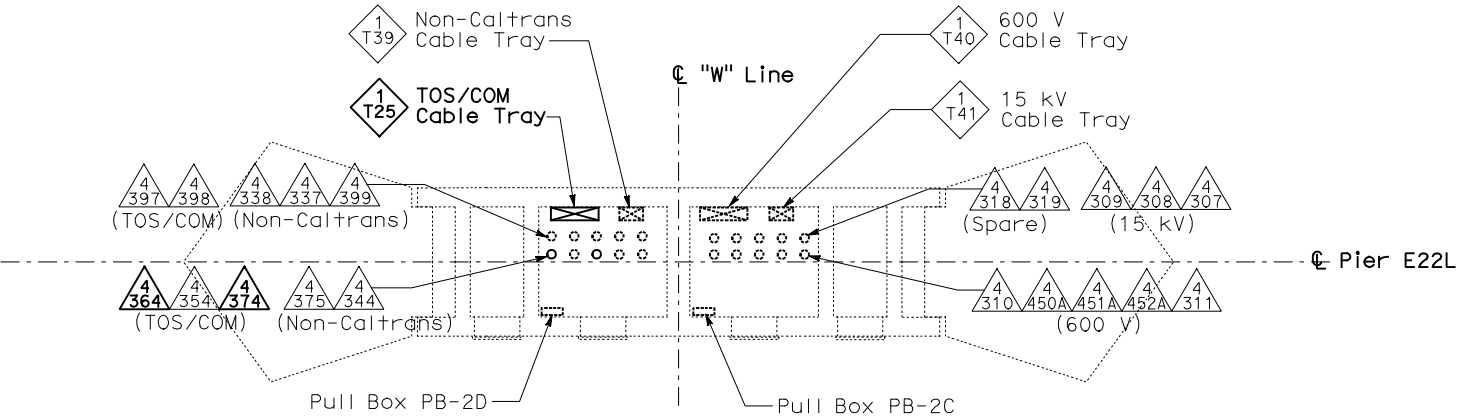

PIER E22L - INSIDE PIER CONDUIT AND CABLE TRAY PLAN

REQUEST FOR INFORMATION NOT ADDRESSED IN THIS CCO REMAIN IN FORCE					
03/08/10	MEP INTEGRATION	SYN	FW	110	
MARK	DATE	DESCRIPTIONS	BY	CH'D	CCO#
REVISIONS					


CONTRACT CHANGE ORDER NO. _____
SHEET _____ OF _____

BRIDGE STRUCTURES GIRDER WESTBOUND
OAKLAND APPROACH STRUCTURES
SCALE 1:50

E-620

THIS PLAN ACCURATE FOR ELECTRICAL WORK ONLY.

ALL DIMENSIONS ARE IN METERS UNLESS OTHERWISE SHOWN

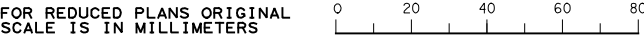

DGN FILE => 04-0120f1_E-620.dgn
USERNAME => ilorico

CU 04251
EA 0120F1

DATE PLOTTED => 06-MAY-2010
TIME PLOTTED => 18:04
LAST REVISION
00-00-00